



FORMAL PROJECT APPROVAL

Name of Project: Fine Arts Complex Vapor Barrier
Project Type: DM and R&R
Location of Project: UAF, Fairbanks Campus, Fine Arts Building Music Wing FS312, Fairbanks
Project Number: 2012045
Date of Request: August 21, 2012

Total Project Cost:	\$ 5.6 Million	
Approval Required:	Full Board	
Prior Approvals:	Preliminary Administrative Approval	August 23, 2012

A Formal Project Approval (FPA) is required for all Capital Projects with a Total Project Cost in excess of \$250,000.

FPA represents approval of the Project including the program justification and need, scope, the total project cost, and the funding and phasing plans for the project. Requests for formal project approval shall include a signed project agreement or facilities pre-design statement, the proposed cost and funding sources for the next phase of the project and for eventual completion of the project, and a variance report identifying any significant changes in scope, budget, schedule, deliverables or prescriptive criteria associated with a design-build project, funding plan, operating cost impact, or other cost considerations from the time the project received preliminary administrative approval. It also represents authorization to complete project development through the schematic design, targeting the approved scope and budget, unless otherwise designated by the approval authority.

Action Requested

“The Facilities and Land Management Committee recommends that the Board of Regents approve the Formal Project Approval request for the University of Alaska Fairbanks Fine Arts Complex Vapor Barrier as presented in compliance with the approved campus master plan, and authorizes the university administration to proceed through Schematic Design not to exceed a Total Project Cost of \$5.6 million. This motion is effective September 27, 2012.”

Project Abstract

Facilities Services maintenance crews have responded to numerous requests to fix problems with standing water, water damaged sheet rock, ceiling tiles and carpet which were originally thought to be roof problems. A USKH report dated May 2012 indicated that humidifying the building and the lack of a continuous vapor barrier were the primary causes of the damage. UAF Environmental Health and Safety Division investigated the building air quality and potential growth of mold. Mold spores were found in the walls of the most problematic rooms. However,

it was determined that they were a common variety and quantities were not found at hazardous levels. Staff pressure to fix the problem continued partially over concerns of potential loss of the program's accreditation. The condensation damage in the Music Department was specifically cited by the most recent accreditation review team as a condition which would lead to loss of accreditation of the Music Department.

This project will correct Music Wing building envelope deficiencies by retrofitting the interior walls with spray foam and other treatments that will increase the R value over the existing condition and simultaneously create a vapor barrier. The retrofit process will include the removal of all materials up to the inside of the exterior concrete tip up panels.

To date, there have not been any feasibility studies to evaluate the cost index to either renovate the existing facility or build a new facility. Given the current TPC estimate of \$130/SF for this project compared to costs to build recent projects such as Life Sciences Facility (\$865/SF), Museum of the North (\$725/SF), Engineering (\$923/SF) and the P3 Dining Addition to Wood Center (\$655/SF), renovation is much less expensive. FCI is 27% including all DM work estimated for the Fine Arts Music Wing.

Variances

None.

Special Considerations

N/A

Total Project Cost and Funding Sources

The total project cost (TPC) is estimated at \$5.6 million based on the May 2012 report. \$600,000 in FY12 General Funds is currently budgeted for this project. An estimated \$440,000 will be spent in the investigative phase. The ultimate design fee is yet to be determined.

<u>Funding Source</u>	<u>Account</u>	<u>Amount</u>
FY 12 General Funds	571319-50216	\$ 600,000
FY 12 Revenue Bonding	TBD	\$ 200,000
FY 13 DM and R&R Funds	571346-50216	\$2,000,000
FY 14 DM and R&R Funds (Future Request)	TBD	\$2,800,000
Total		\$5,600,000

Annual Program and Facility Cost Projections

	<u>Amount</u>
Total Annual Program Cost Increase	NA
Total Annual O&M Cost	decrease in annual repair costs
Total Annual Renewal and Replacement Cost	NA
Total Annual Cost Projections	decrease

Project Delivery Method

The Construction Manager at Risk (CM@Risk) project delivery method is the intended delivery method for this project. The CM@Risk process should result in lower costs and less chance of cost overruns on this complete project, thus providing best value for the University. UAF expects

to achieve best value for the Fine Arts Vapor Barrier project with the CM@Risk approach, because the University will be able to select a contractor who has expertise in the construction and application of complete building thermal envelopes. Opportunities for value engineering identified by the CM@Risk contractor during the pre-construction services (design) phase can also be incorporated at an early stage, ensuring maximum value for such opportunities.

The exterior wall renovation will affect every perimeter room and to minimize disruption, we want to complete the project in one summer. The early contractor involvement helps reduce the risk that unknown conditions are uncovered during later construction phases which can often require costly design modifications and change orders. Furthermore, the CM@Risk contractor may perform selective demolition during the early stages of the design process which will increase the chances of capturing hidden conditions within the 44-year old building as well as provide an opportunity to test application methods in advance of both costly design work and major construction phases. Contractor input during the design phase regarding issues of constructability, project phasing and integrated building components will be crucial to the success of this project. Project phasing is important due to the very tight schedule and large impact to the Music Department if the work is not done in a timely manner.

Anticipated Schedule

Investigation	June 2012
Designer Selection	October 2012
CM@R Selection	October 2012
Design Completion	March 2013
Begin Construction	April 2013
End Construction	September 2013

Affirmation

This project complies with Regents' Policy and the campus master plan.

Supporting Documents

- Project Agreement is not yet available.
- One-page Project Budget
- Drawings




UNIVERSITY OF ALASKA	
Project Name: Fine Arts Complex Vapor Barrier and Installation	
MAU: UAF	
Building: Fine Arts Music Wing	Date: August 21, 2012
Campus: UAF	Prepared By: Mary Pagel
Project #: 2012045 FAVB	Account No.: 571319-50216
Total GSF Affected by Project: 42905	
PROJECT BUDGET	FPA Budget
A. Professional Services	
Advance Planning, Program Development	\$30,000
Consultant: Design Services	\$358,928
Consultant: Construction Phase Services	\$20,000
Consul: Extra Services (List: _____)	\$0
Site Survey	\$0
Soils Testing & Engineering	\$0
Special Inspections	\$0
Plan Review Fees / Permits	\$0
Other	\$0
<i>Professional Services Subtotal</i>	\$408,928
B. Construction	
General Construction Contract (s)	\$3,407,752
Other Contractors (List: _____ HVAC testing and balanceing _____)	\$50,000
Construction Contingency @ 15%	\$518,663
<i>Construction Subtotal</i>	\$3,976,415
<i>Construction Cost per GSF</i>	\$92.68
C. Building Completion Activity	
Equipment	\$0
Fixtures	\$0
Furnishings	\$0
Signage not in construction contract	\$0
Move-Out Cost/Temp. Reloc. Costs	\$260,000
Move-In Costs	\$200,000
Art	\$0
Other (List: _____)	\$0
OIT Support	\$20,000
Maintenance/Operation Support	\$70,000
<i>Building Completion Activity Subtotal</i>	\$550,000
D. Owner Activities & Administrative Cost	
DDC Direct Management Cost (recharge)	\$222,090
Project Management and Facilities Engineers Review and Inspection	\$191,390
Salary Contingency for possible 2 season construction schedule	\$158,500
Misc Expenses: Parking/staging	\$90,000
<i>Owner Activities & Administrative Cost Subtotal</i>	\$661,980
E. Total Project Cost	\$5,600,000
<i>Total Project Cost per GSF</i>	\$130.52
F. Total Appropriation(s)	\$5,600,000

 

FILE: F:\217019\DWGS\A\SHEETS\217015_T1.DWG PLOTTED: May 17, 2012 - 3:52:59 PM (COPY PLOT)

These drawings constitute an appendix to the Fine Arts Music Wing "Vapor Barrier & Wet Analysis Phase 2" Report Document.

T1.0	Location Plan and Drawing Index
A2.1	Level One Floor Plan
A2.2	Level Two Floor Plan
A2.3	Level Three Floor Plan
A3.1	North and East Exterior Elevations
A3.2	South and West Exterior Elevations
A3.4	Wall Sections

[illegible]

-  Access hatch installed 2010
-  Access hatch installed 2011
-  Test hole cut 2012

 Location of Ceiling Drips
 - - - - - Location of Severe Condensation at Walls
 Flooding Locations on Floors

 Interior Wall Retrofit Locations
 Window to be Relocated to Thermal Plane

 TYP AT MOST INTERIOR -
EXTERIOR WALL
INTERSECTIONS

NORTH WALL AREA OF
SUSPECTED GROUND WATER
INTRUSION

OBSERVATION MATCH LOCATED
AT CEILING LEVEL

NOT FOR CONSTRUCTION

Data Summary:

[illegible]

USKH
 UNITED STATES ARCHITECTURAL
 ARCHITECTURE • ENGINEERING • SURVEY
 CONSULTING • ENVIRONMENTAL SCIENCE

2016 W Street
Annapolis, AnneC 09062
(301) 270-0900

Sold 05b American
Suite 102
Farmingdale, AnneC 00701
(504) 455-2120

2017 C&D-Gen Drive
Suite 201
Jupiter, AnneC 33458
(561) 755-2551

2018 W Chesley Highway
Suite 200
Greenville, AnneC 29606
(843) 836-4900

401 W 10th Avenue
Suite 200
Annapolis, AnneC 09061
(301) 274-0000

Project
Fine Arts Music Win
Vapor Barrier &
Wall Analysis -
Phase 2

University of Alaska Fairbanks
Fairbanks, AK

Project Mgr.	G. Pohl	
Design	CLT	
Checked	GMP	
Date	18 May 2011	

Sheet Contents:
**LEVEL ONE
FLOOR PLAN**


Chand. No.:

A2.1

E USKH W.O. 121781

11 x 17 SHEETS ARE HALF SIZE

E USKH W.O. 1217815

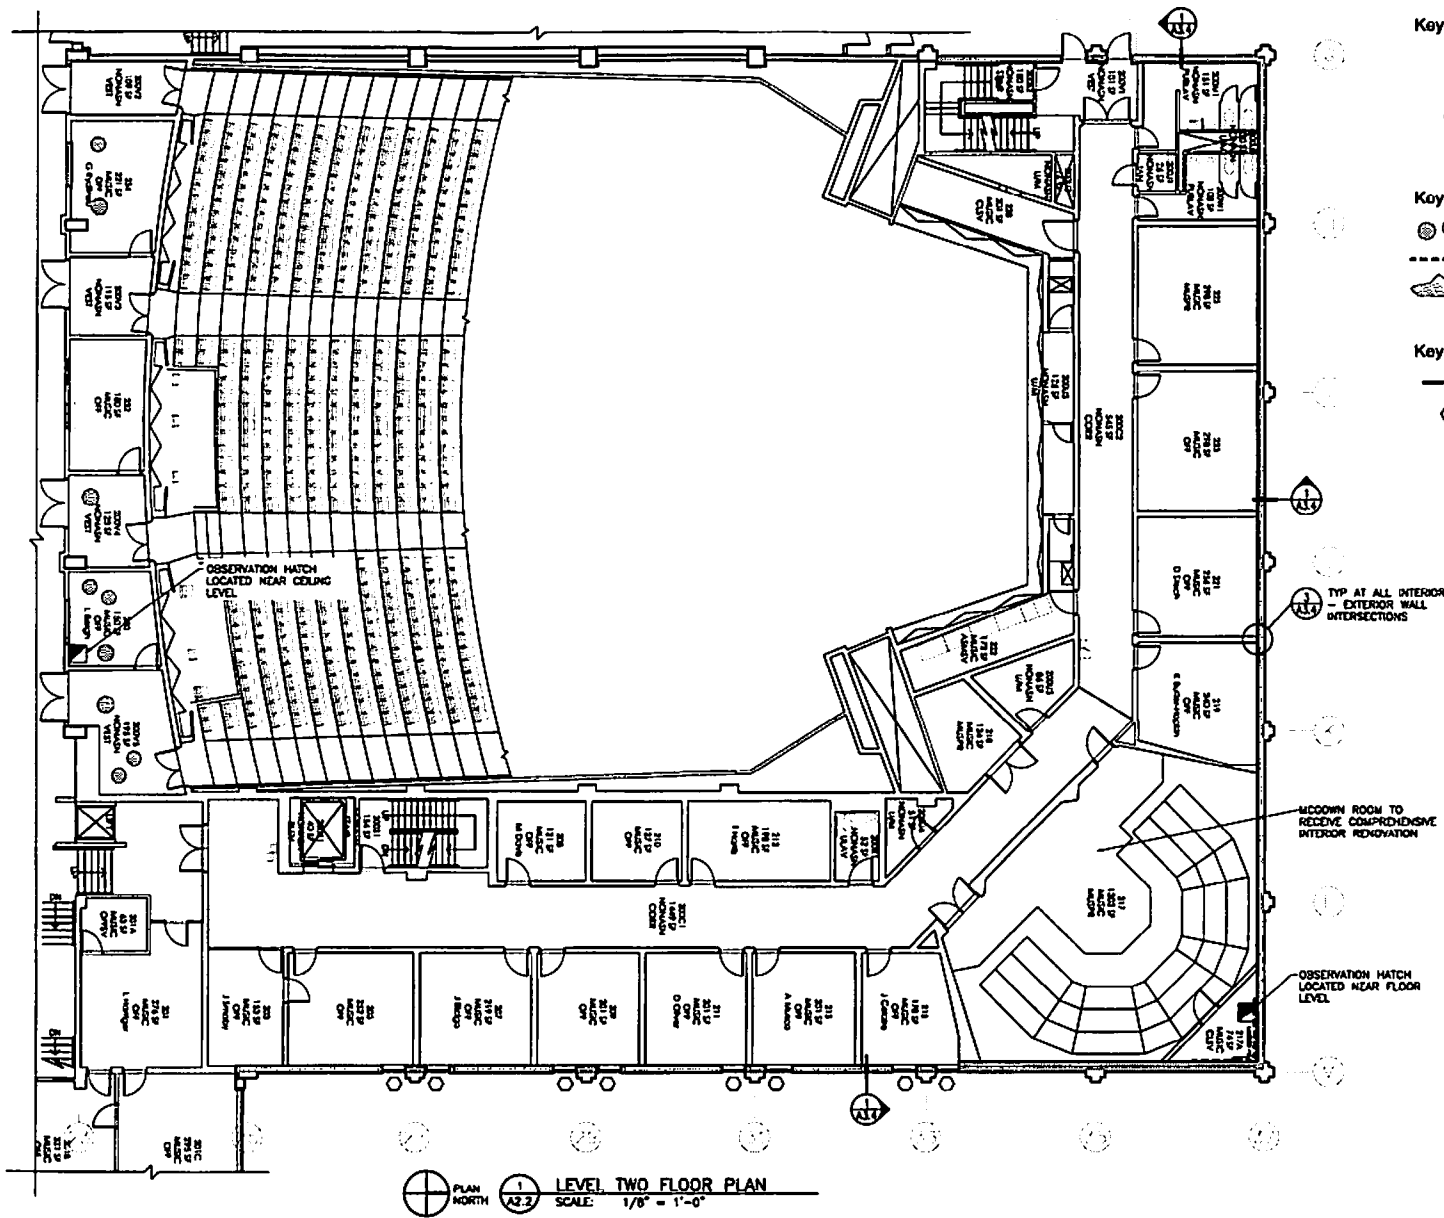

Key to Wall Cavity Observation Points

- Access hatch installed 2010
- Access hatch installed 2011
- Test hole out 2012

Key to Observed Moisture Problems

- Location of Ceiling Drips
- Location of Severe Condensation at Walls
- Flooding Locations on Floor

Key to Retrofit Recommendations

- Interior Wall Retrofit Locations
- Window to be Relocated to Thermal Plane

NOT FOR CONSTRUCTION

Date Completed: 16 May 2012

Revision: 1

Drawn: CLT

Checked: GHP

Date: 16 May 2012

Sheet Contents: LEVEL TWO FLOOR PLAN

Sheet No.: A2.2

Project: Fine Arts Music Wing Vapor Barrier & Wall Analysis - Phase 2

University of Alaska Fairbanks Fairbanks, AK Project No. 2012048 FAVB


Project Mgr.: G. Pohl

Drawn: CLT

Checked: GHP

Date: 16 May 2012

11 x 17 SHEETS ARE HALF SIZE USKH W.O. 1217915

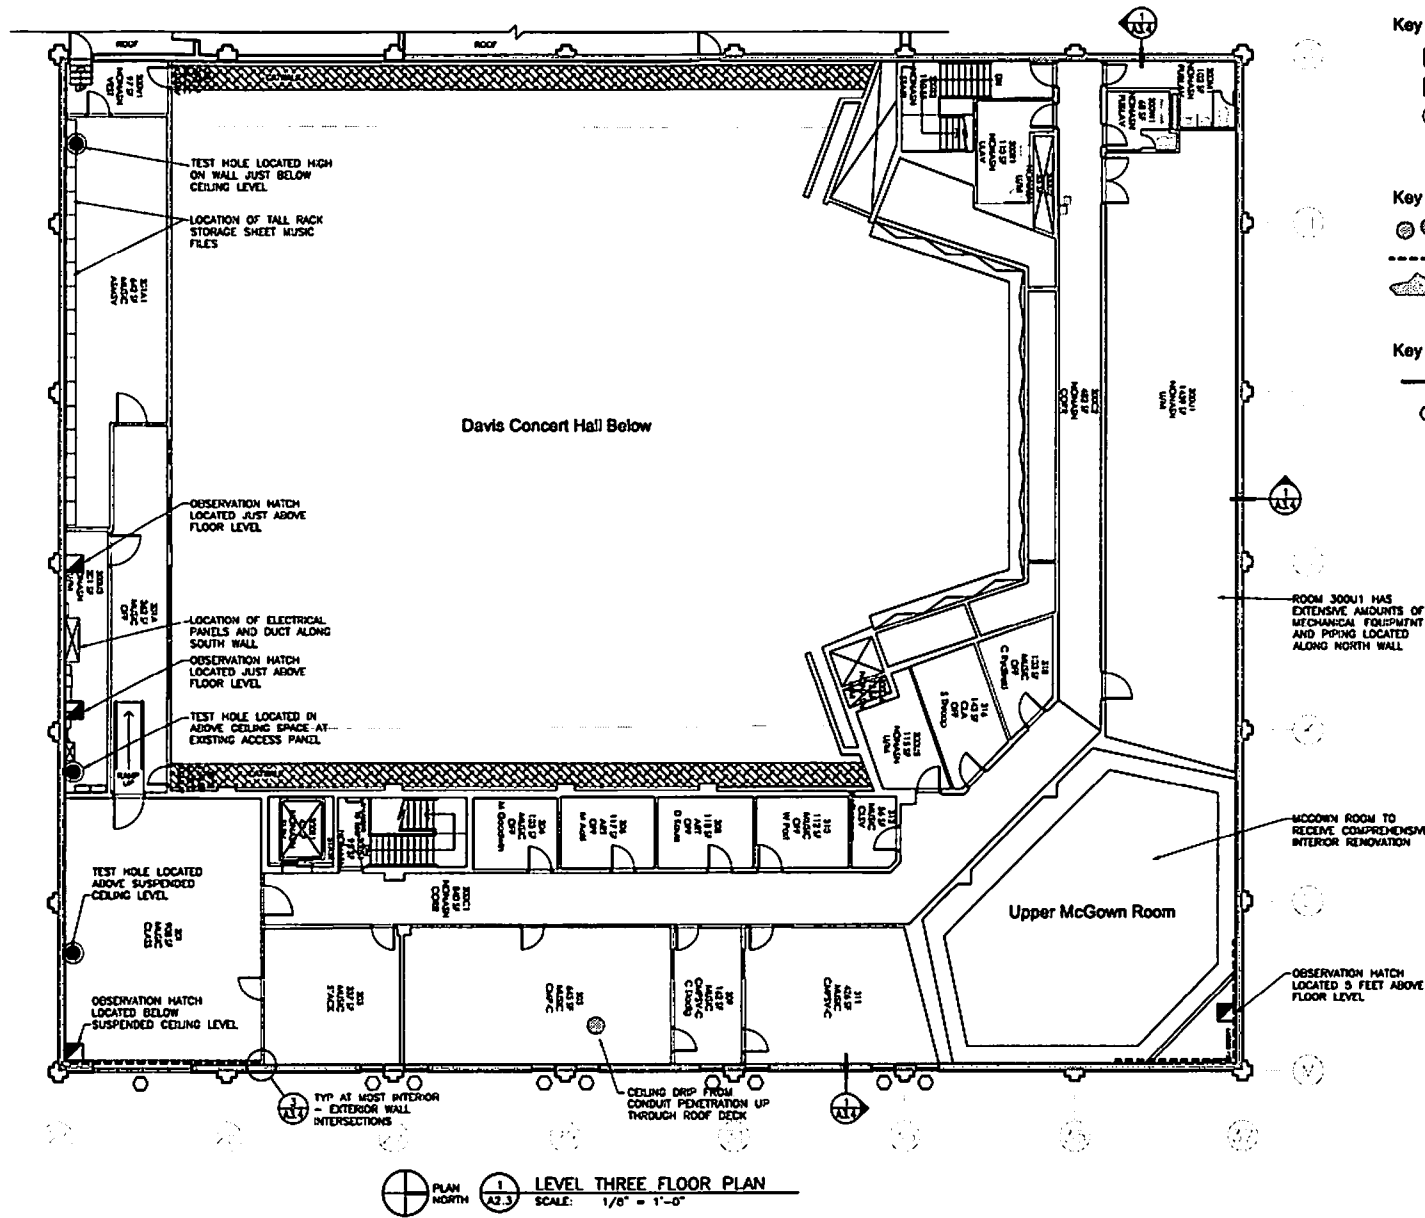

Key to Wall Cavity Observation Points

- Access hatch installed 2010
- Access hatch installed 2011
- Test hole cut 2012

Key to Observed Moisture Problems

- Location of Ceiling Drips
- Location of Severe Condensation at Walls
- ▲ Flooding Locations on Floors

Key to Retrofit Recommendations

- Interior Wall Retrofit Locations
- Window to be Relocated to Thermal Plane

NOT FOR CONSTRUCTION

Date Stamped: _____

USKH
 USKH W.O. 1217915
 1010 W. 10th Avenue, Suite 200
 Anchorage, Alaska 99501
 (907) 774-0000
 Fax: (907) 774-0001
 Email: info@uskh.com
 Website: www.uskh.com

Project:
Fine Arts Music Wing Vapor Barrier & Wall Analysis - Phase 2

University of Alaska Fairbanks
 Project No. 2012045 FAWD

Project Mgr.	G. PoH
Drawn	CLT
Checked	GMP
Date	19 May 2012


Sheet Contents:
LEVEL THREE FLOOR PLAN

Sheet No.:
A2.3

11 x 17 SHEETS ARE HALF SIZE


USKH W.O. 1217915

FILE: S:\1217915\DWG\1217915_A3.1.dwg PLOTTED: May 18, 2012 - 10:12:10 AM (Corty Reed)

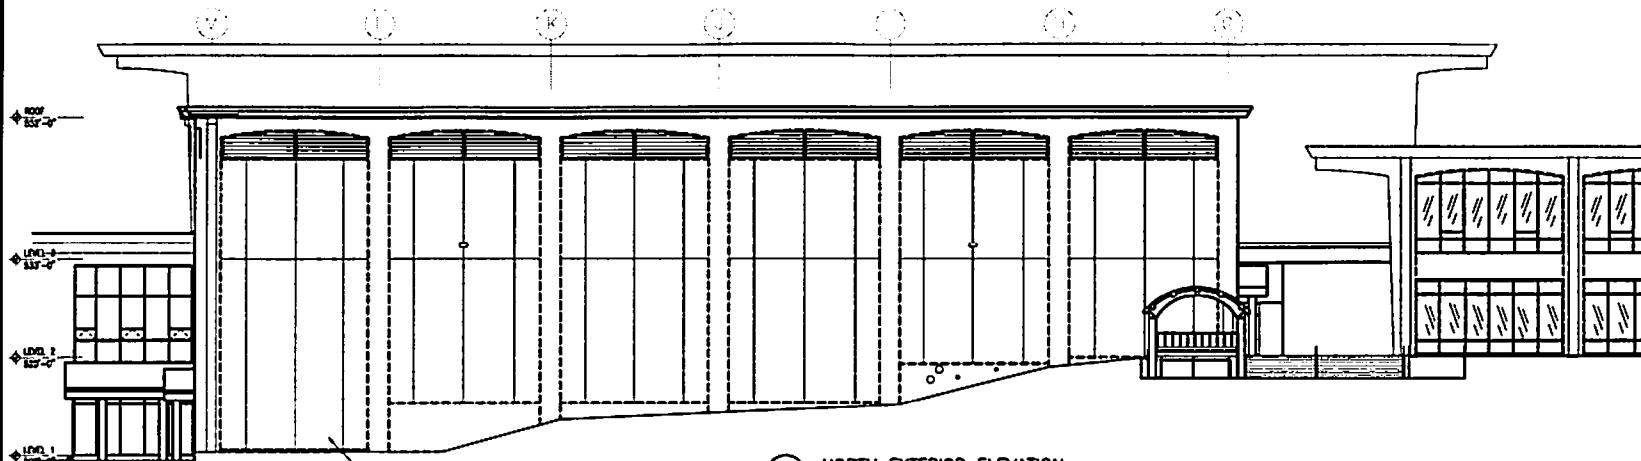

1 NORTH EXTERIOR ELEVATION
SCALE: 1/8" = 1'-0"

PRACTICE ROOM 129 BEYOND,
SUSPECTED GROUND WATER
INTRUSION AT FOUNDATION

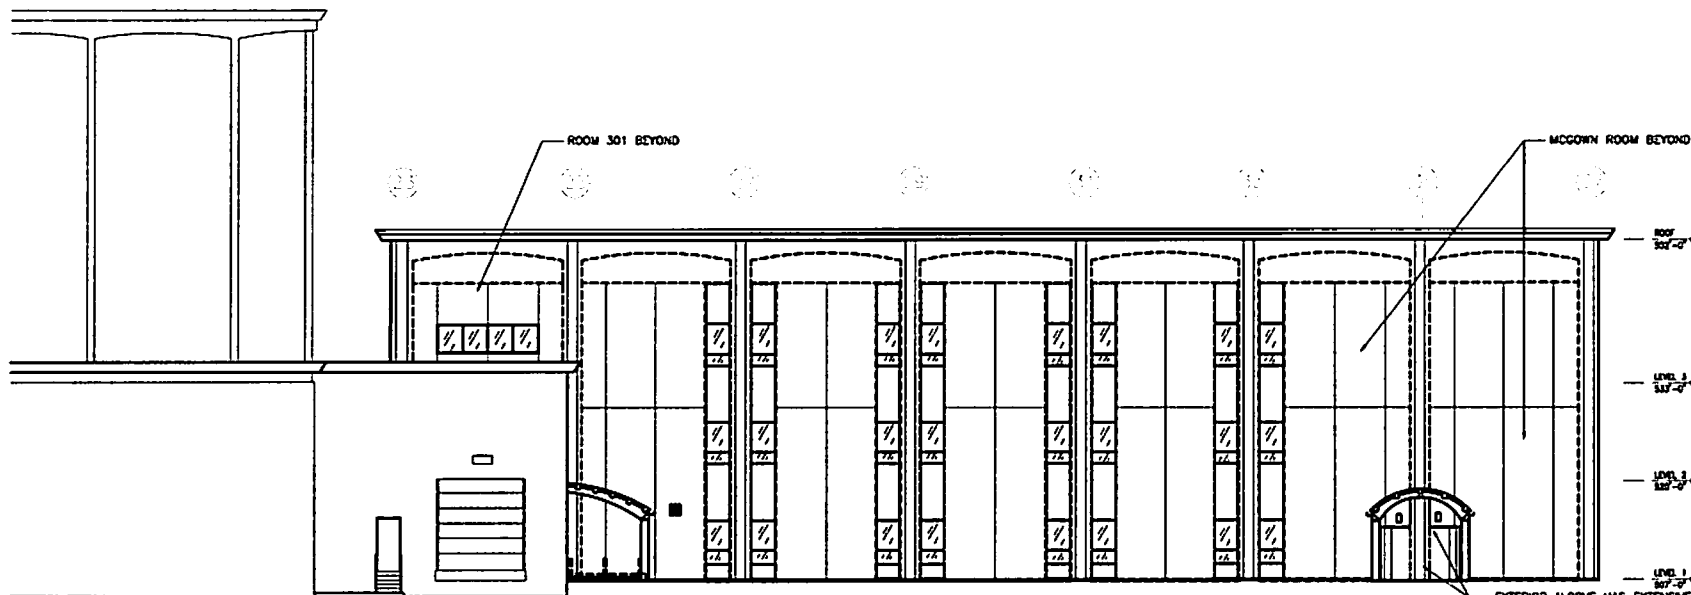

2 EAST EXTERIOR ELEVATION
SCALE: 1/8" = 1'-0"

EXTERIOR ALCOVE HAS EXTENSIVE
MOISTURE DAMAGE AT SOFFIT AND
WALLS

11 x 17 SHEETS ARE HALF SIZE

NOT FOR CONSTRUCTION

Disc Deleted

USKH
ARCHITECTS • ENGINEERS • SURVEYORS
PLANNING • ENVIRONMENTAL SERVICES

2010 © USKH
Architects, Inc. 2010
2011 © USKH
Architects, Inc. 2011
2012 © USKH
Architects, Inc. 2012
2013 © USKH
Architects, Inc. 2013
2014 © USKH
Architects, Inc. 2014
2015 © USKH
Architects, Inc. 2015
2016 © USKH
Architects, Inc. 2016
2017 © USKH
Architects, Inc. 2017
2018 © USKH
Architects, Inc. 2018
2019 © USKH
Architects, Inc. 2019
2020 © USKH
Architects, Inc. 2020
2021 © USKH
Architects, Inc. 2021
2022 © USKH
Architects, Inc. 2022

Project:
Fine Arts Music Wing
Vapor Barrier &
Wall Analysis -
Phase 2

University of Alaska Fairbanks
Fairbanks, AK
Project No. 2012043 FAIVB

Project Mgr. G. Pohl
Drawn C.L.T.
Checked G.H.P.
Date 18 May 2012


Sheet Contents:
NORTH AND EAST
EXTERIOR
ELEVATIONS

Sheet No.:
A3.1

USKH W.O. 1217915


1 SOUTH EXTERIOR ELEVATION
A3.2 SCALE: 1/8" = 1'-0"

— SYMPHONY OFFICE 230
LOCATED BELOW

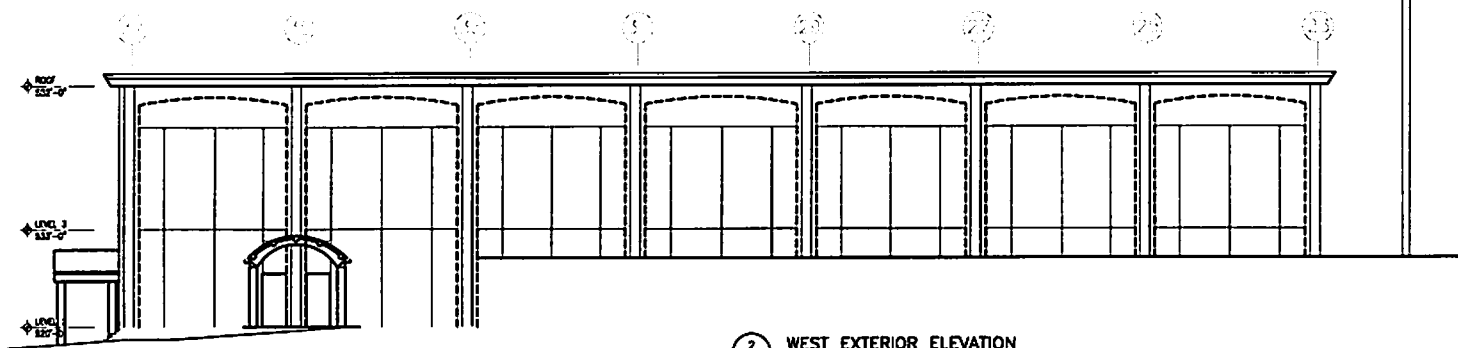


2 WEST EXTERIOR ELEVATION
A3.2 SCALE: 1/8" = 1'-0"


A3.2

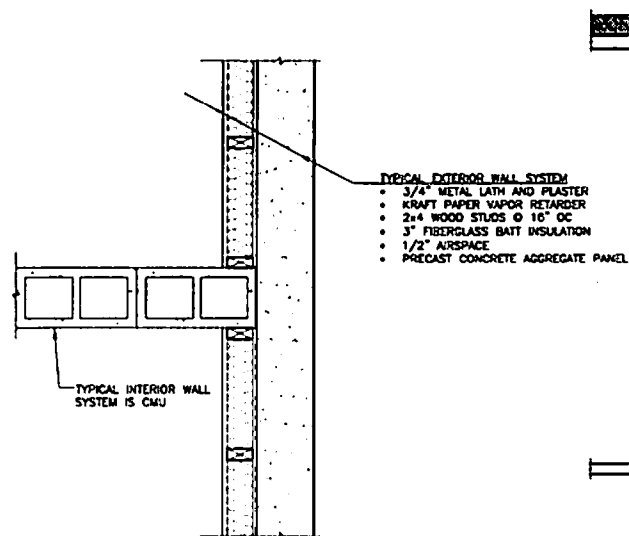

3 TYPICAL INTERIOR-EXTERIOR WALL INTERSECTION
SCALE: 1 1/2" = 1'-0"

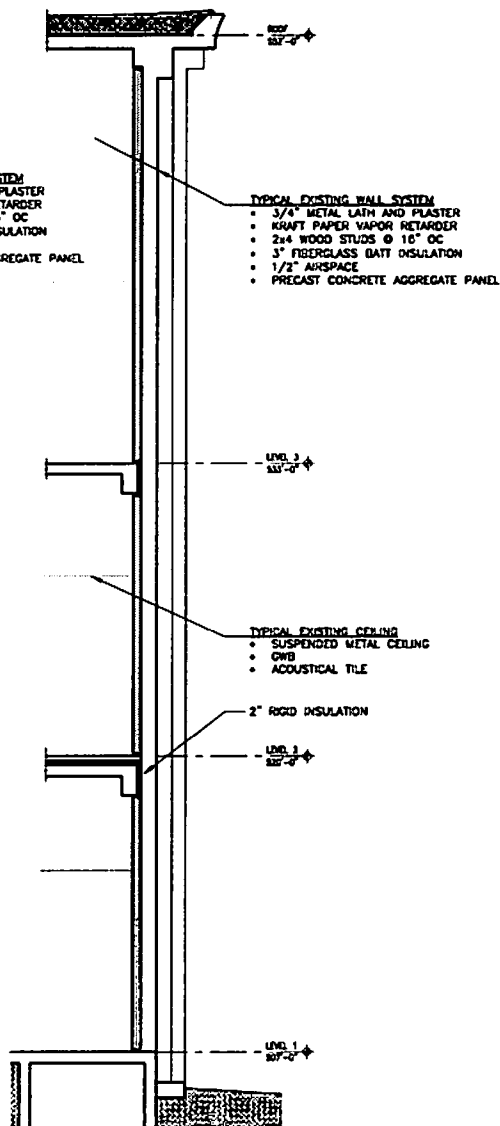

1 TYPICAL EXISTING WALL SECTION
SCALE: 3/8" = 1'-0"

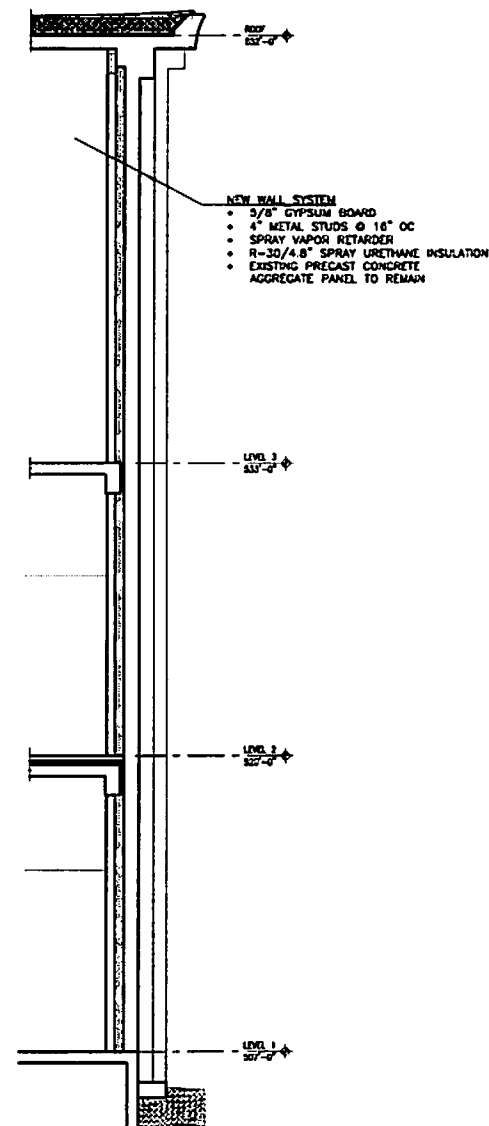

2 TYPICAL RETROFIT WALL SECTION
SCALE: 3/8" = 1'-0"

11 x 17 SHEETS ARE HALF SIZE

NOT FOR CONSTRUCTION

Drawn: [Blank]

Check: [Blank]

Date: [Blank]

USKH
Architectural • Engineering • Surveying
Planning • Environmental Services

2018 W. Street
Anchorage, Alaska 99501
(907) 273-4500

300 4th Avenue
Suite 100
Fairbanks, Alaska 99701
(907) 452-0121

401 F. Carlson Drive
Suite 201
Anchorage, Alaska 99501
(907) 755-0001

201 W. Muldoon Highway
Suite 200
Wasilla, Alaska 99607
(907) 274-0700

401 W. 10th Avenue
Suite 200
Anchorage, Alaska 99501
(907) 270-0000

Project:
**Fine Arts Music Wing
Vapor Barrier &
Wall Analysis -
Phase 2**

University of Alaska Fairbanks
Fairbanks, AK
Project No. 2012043 FAYB

Project Mgr.	G. PCH
Drawn	CLT
Checked	GMP
Date	18 May 2012

Sheet Contents:

WALL SECTIONS

Sheet No.:
A3.4

USKH W.O. 1217815